ASSESSOR'S SUBDIVISION OF PART OF SECTION 21

TOWNSHIP 38 RANGE 7 EAST OF THE 3RD PRINCIPAL MERIDIAN

Ordinance # 237
Vacating a portion of 1st Street
between Main St. + Route 47
Rec 1-5-1977
Doc. 1390973

POOR ORIGINAL
Recorder Not Responsible
For Reproduction

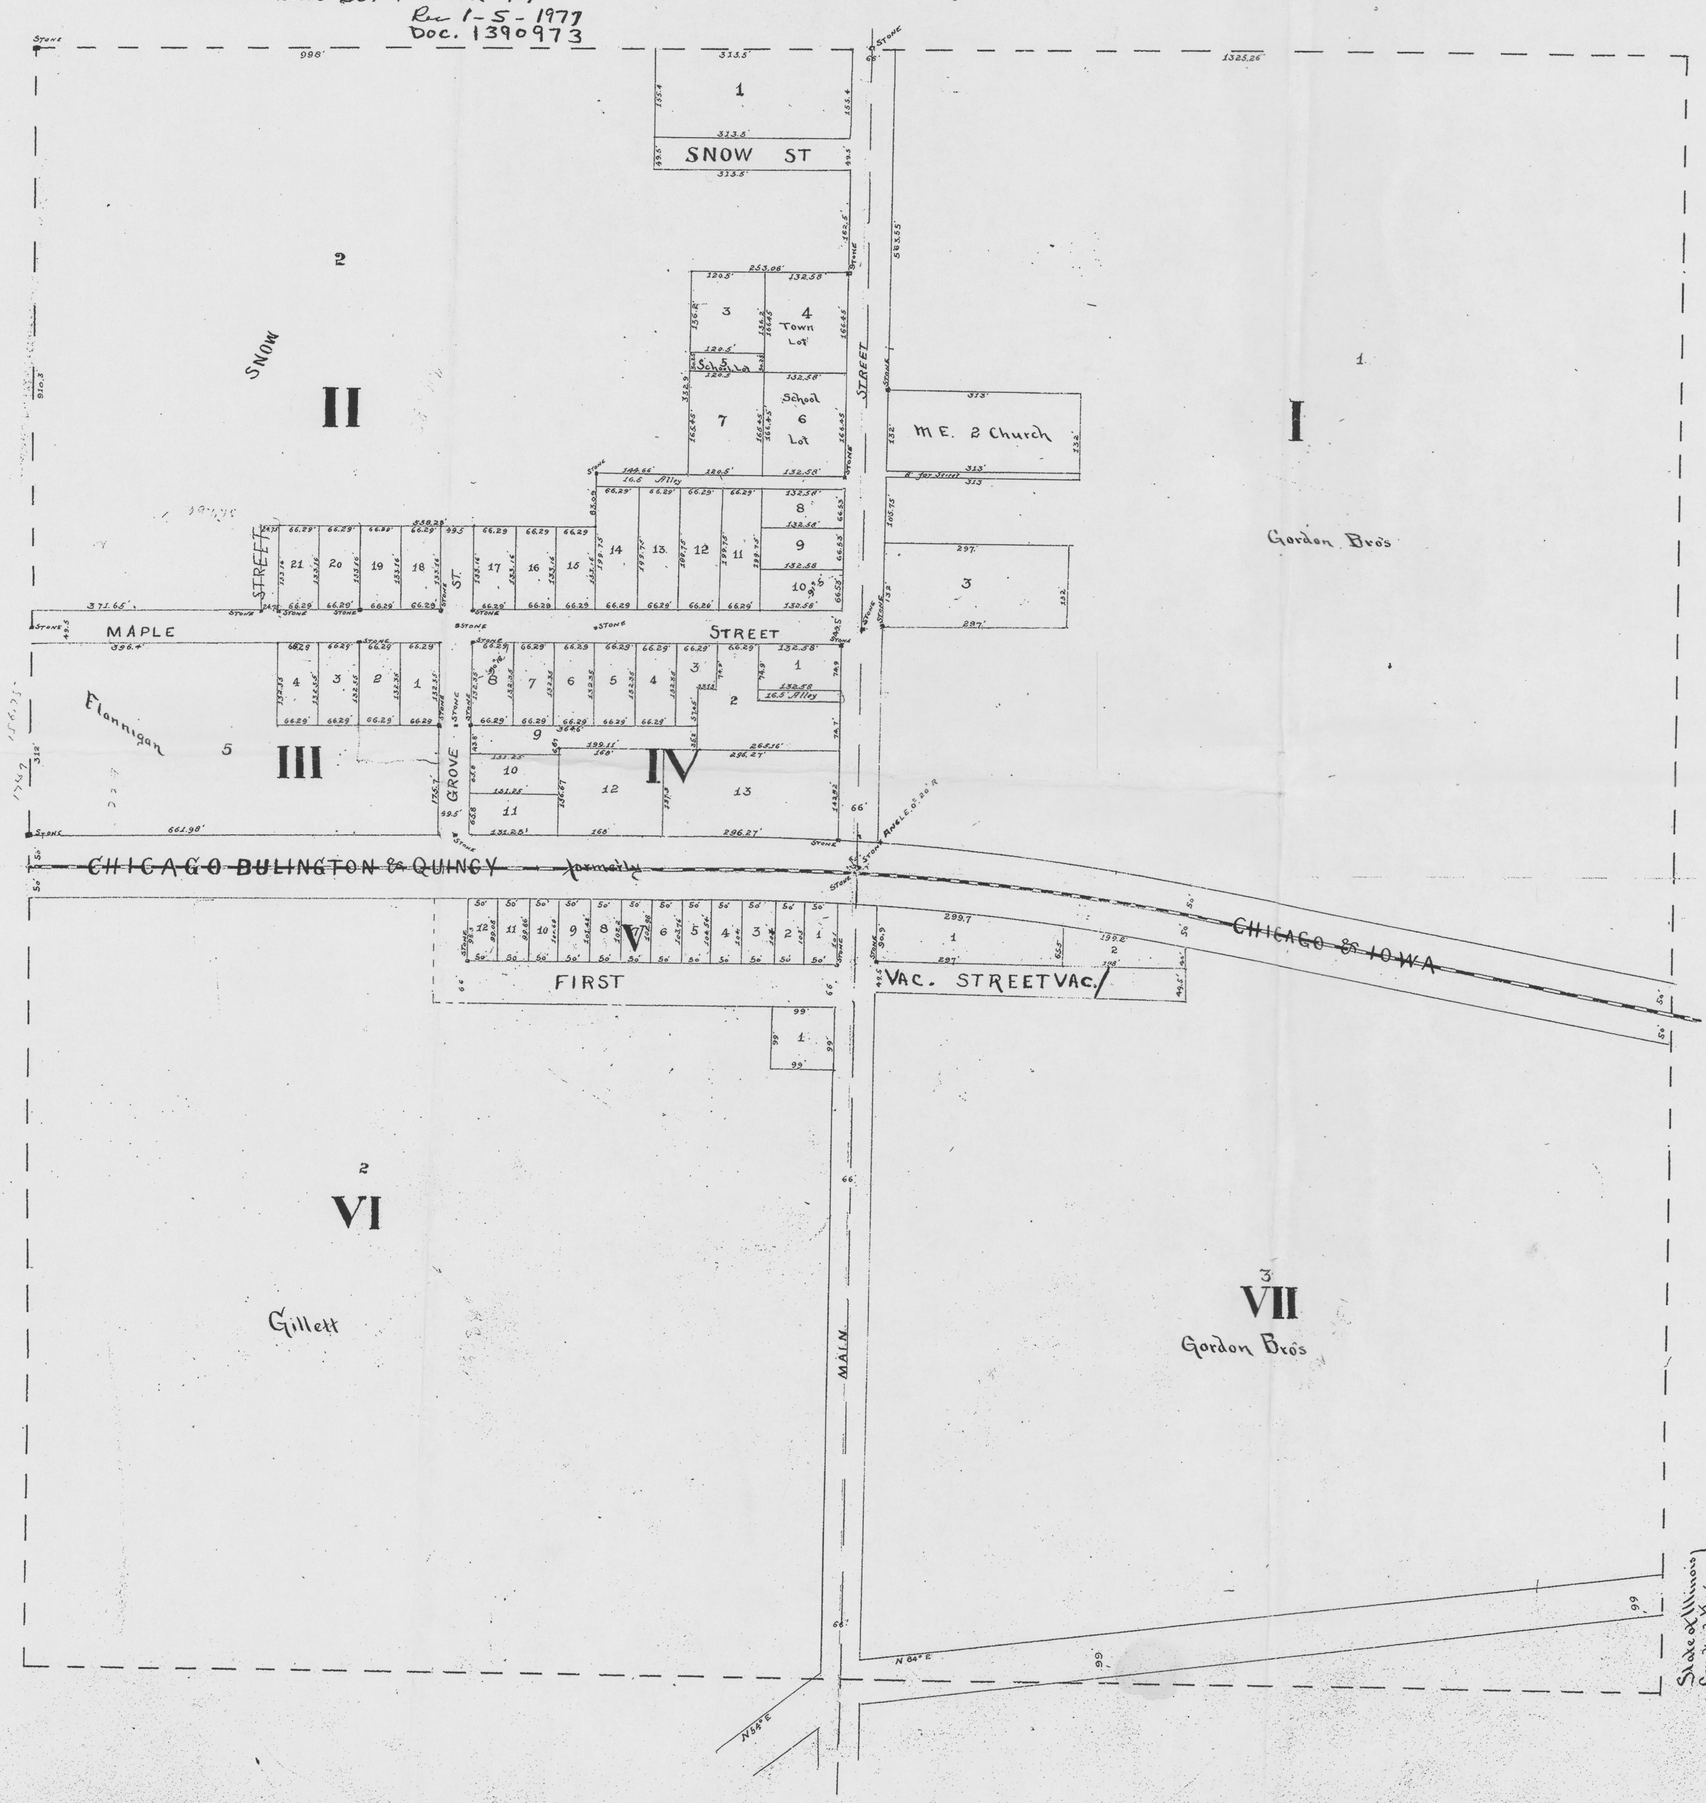

State of Illinois
County of Kane
City of Elgin } ss

This certifies that I have carefully surveyed Section Twenty-one (21) Township Thirty-eight (38) Range Seven (7) East of the Third (3rd) Principal Meridian, and that by the direction of Charles W. Raymond, County Clerk of the County and State aforesaid, I have subdivided and plotted the South-west Quarter (SW¼) of the North-east Quarter (NE¼) of the South-west Quarter, and the North-west Quarter (NW¼) of the South-east Quarter (SE¼) of said Section Twenty-one (Sec 21) into Lots, Blocks, Streets and Alleys as shown by the plat hereon drawn. The true center of said section, which I have established by locating the Section Corners and intersecting straight lines from the Quarter Corners equidistant and on line from said Section Corners, is shown by the Green lines and is Seven (7) feet South and Six and on half (6½) feet West from the stone supposed to be said center and recognized by the deeds of said Section. The stones marked in red represent the monuments set by H. Chapman, Surveyor, and used by George Wilder, Surveyor. New Monuments stones are set as represented on the accompanying Map which correctly represents the same, and which gives all measurements in feet and decimals from Street lines and gives the lots their pro rata share of the surplus found.

Witness my hand and seal at Elgin this Thirtieth day of April AD 1895.
Geo U. Nichols CE Seal
Surveyor

State of Illinois
County of Kane } ss

I Charles W. Raymond, County Clerk of Kane County, Illinois, do hereby certify that, after receiving and placing on file a written agreement from the owners, I caused to be made the foregoing survey, subdivision and plat for the uses and purposes of describing the same for assessment purposes and I accept the same and adopt said Map under the name and style of Assessor's Subdivision of part of Section 21, Township 38, Range 7, East of the 3rd Principal Meridian.
Witness my hand and seal of Kane County at Geneva this First day of May AD 1895.
Chas W Raymond Seal
County Clerk

State of Illinois
County of Kane } No 17905

The above Instrument was filed for record on the 1st day of May AD 1895 at 11:30 o'clock A.M. and duly recorded in Volume 14 Page 3.
Joseph Ingham
Recorder